

Disclaimer

This drawing should not be scaled.


The contractor is to check all dimensions on site and inform the contract administrator/project manager of any discrepancies.

All work is to comply in every aspect with the Building Regulations, Codes of Practice and British Standards.


This drawing is to be read in conjunction with all other contract drawings and specifications.

This drawing is copyrighted and must not be reproduced in any format or disclosed to any third party without the written consent of Tuffin Ferraby Taylor LLP.

rev date details by

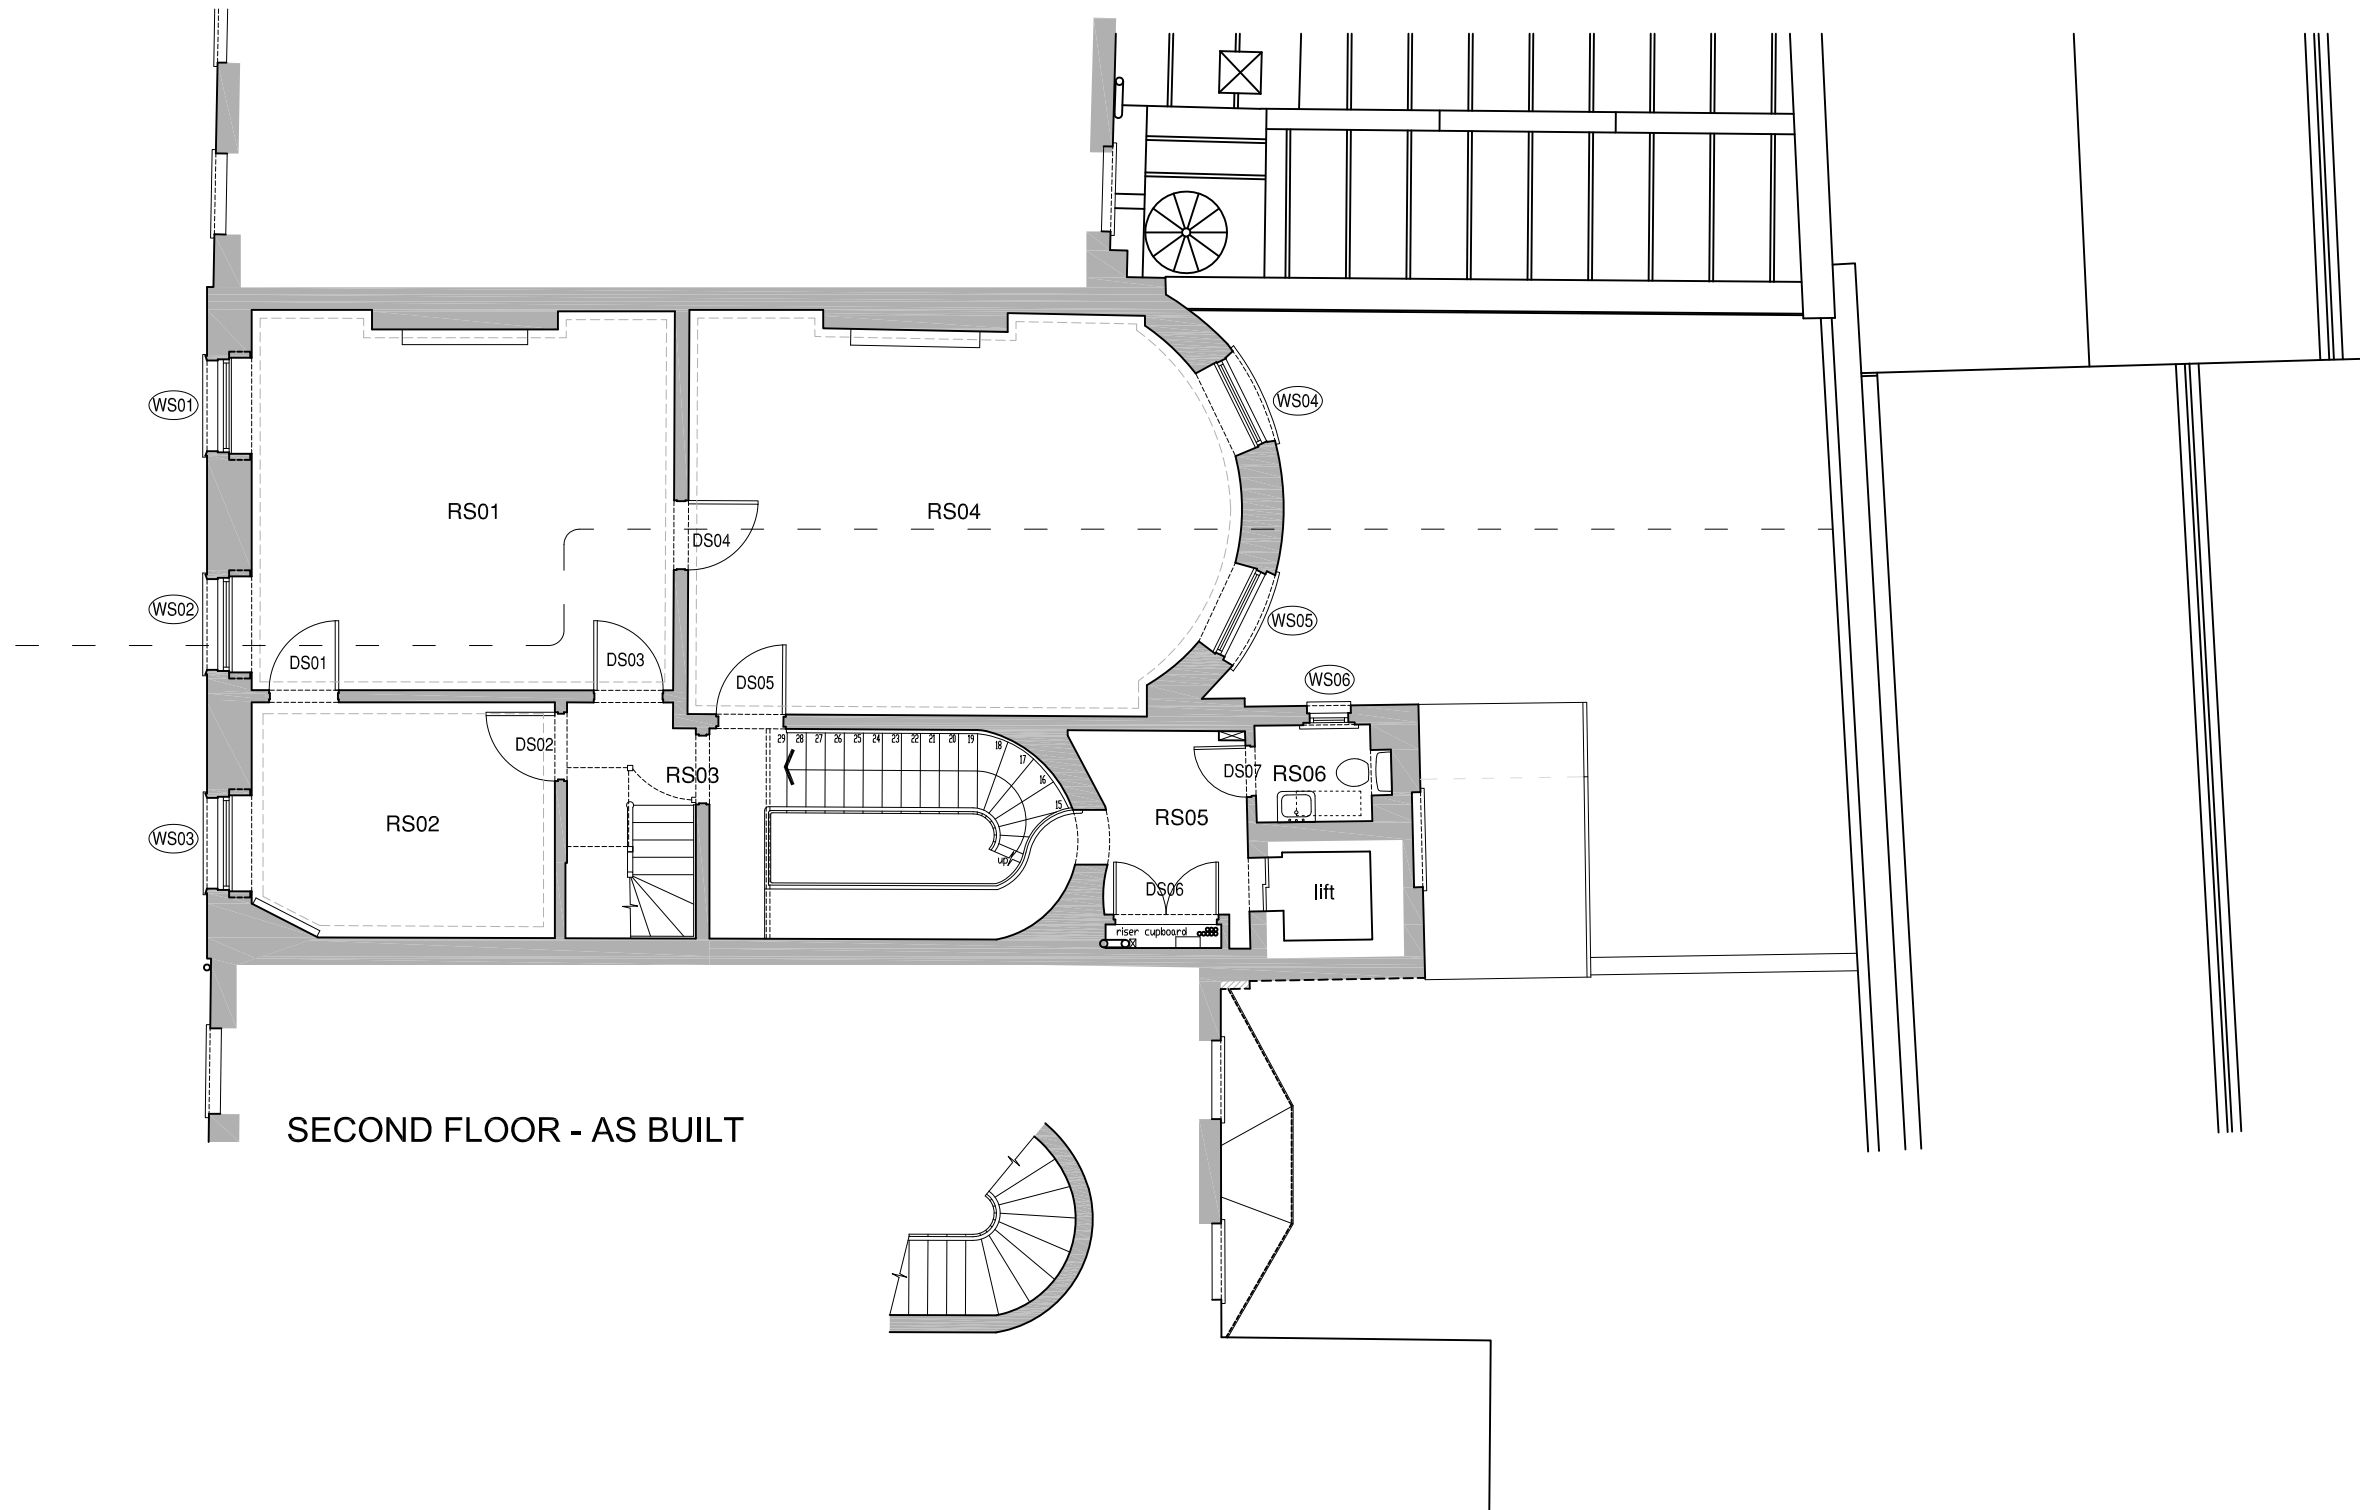

SECOND FLOOR - AS BUILT

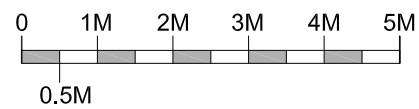

SCALE 1:100

CLIENT Bedford Estates
PROJECT 25 Bedford Square, London WC1B 3HW
DRAWING AS BUILT - Second Floor

DRAWN
SCALE @ A3 1:100
DATE Aug 16

TFT
Tuffin Ferraby Taylor LLP

PROJECT No. DRAWING No. REV
26901 25-P02