

**Disclaimer**

This drawing should not be scaled.


The contractor is to check all dimensions on site and inform the contract administrator/project manager of any discrepancies.

All work is to comply in every aspect with the Building Regulations, Codes of Practice and British Standards.


This drawing is to be read in conjunction with all other contract drawings and specifications.

This drawing is copyrighted and must not be reproduced in any format or disclosed to any third party without the written consent of Tuffin Ferraby Taylor LLP.

rev date details by

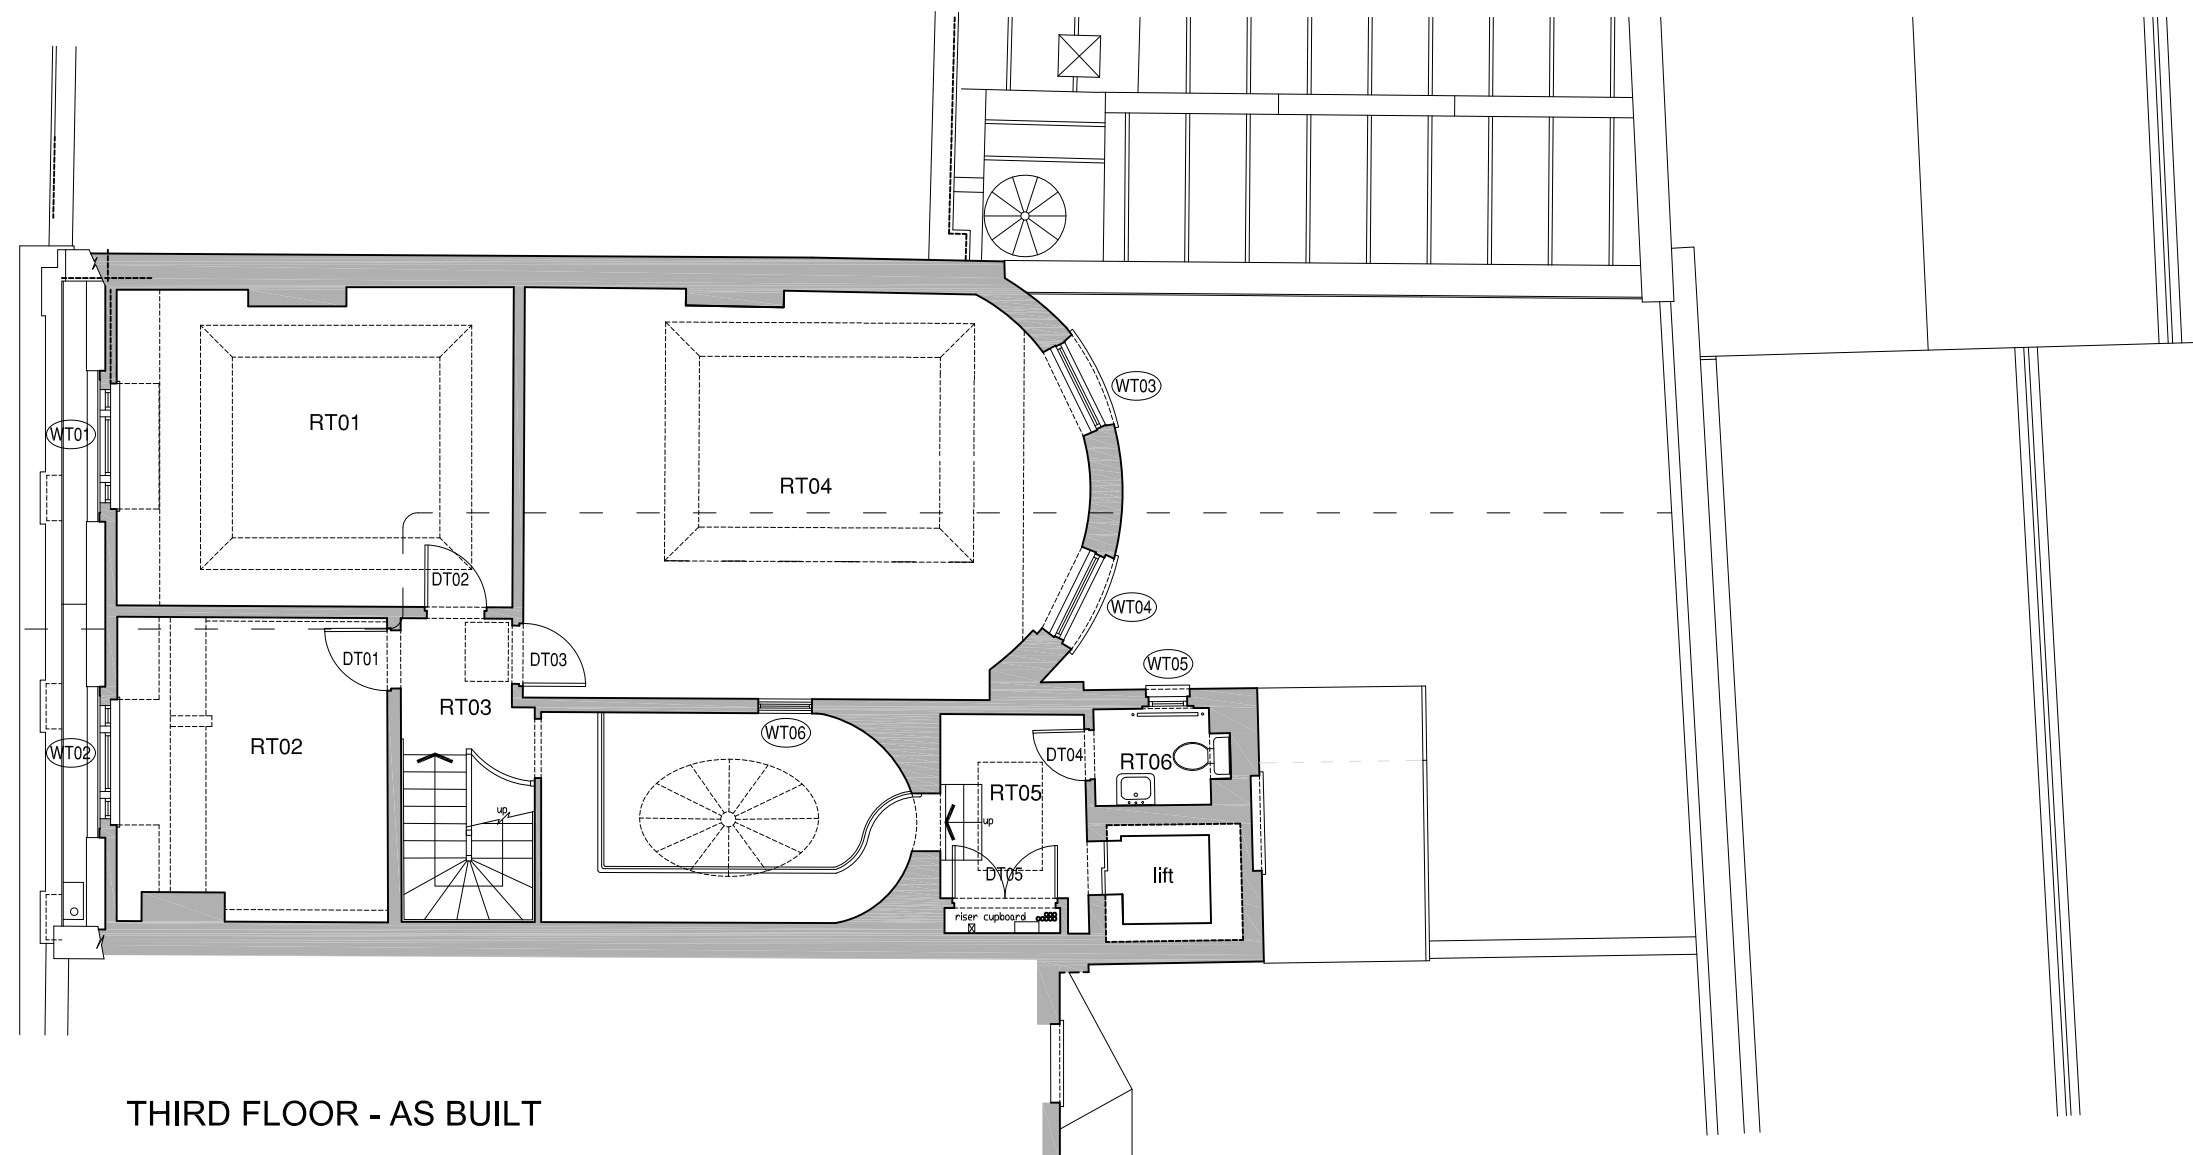

THIRD FLOOR - AS BUILT

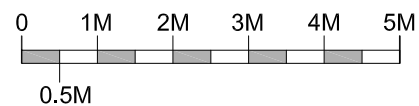

SCALE 1:100

CLIENT Bedford Estates  
PROJECT 25 Bedford Square, London WC1B 3HW  
DRAWING AS BUILT - Third Floor

DRAWN  
SCALE @ A3 1:100  
DATE Aug 16



Tuffin Ferraby Taylor LLP

PROJECT No. DRAWING No. REV  
26901 25-P03